





P012126
VIEW W

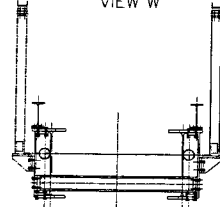


*COPY OF THIS
DRAWING
REQUIRED*

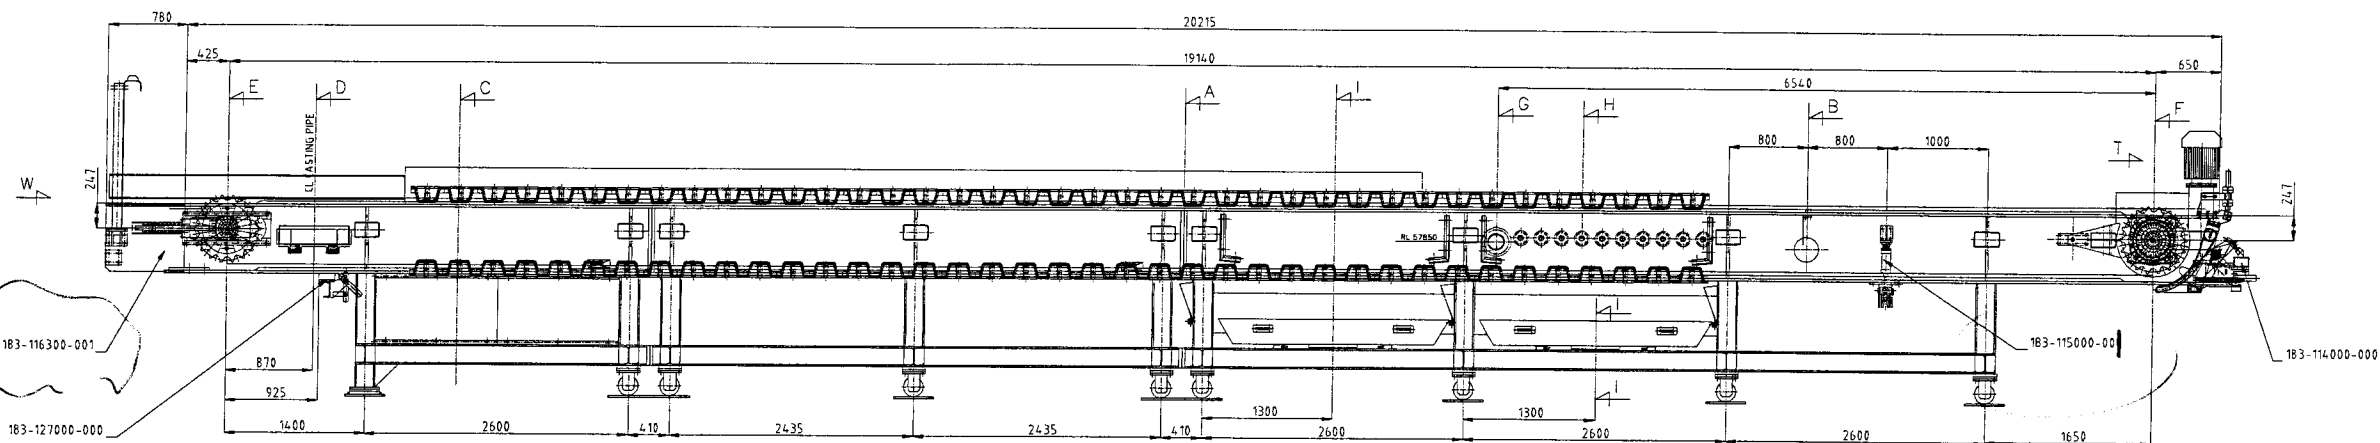


VIEW J

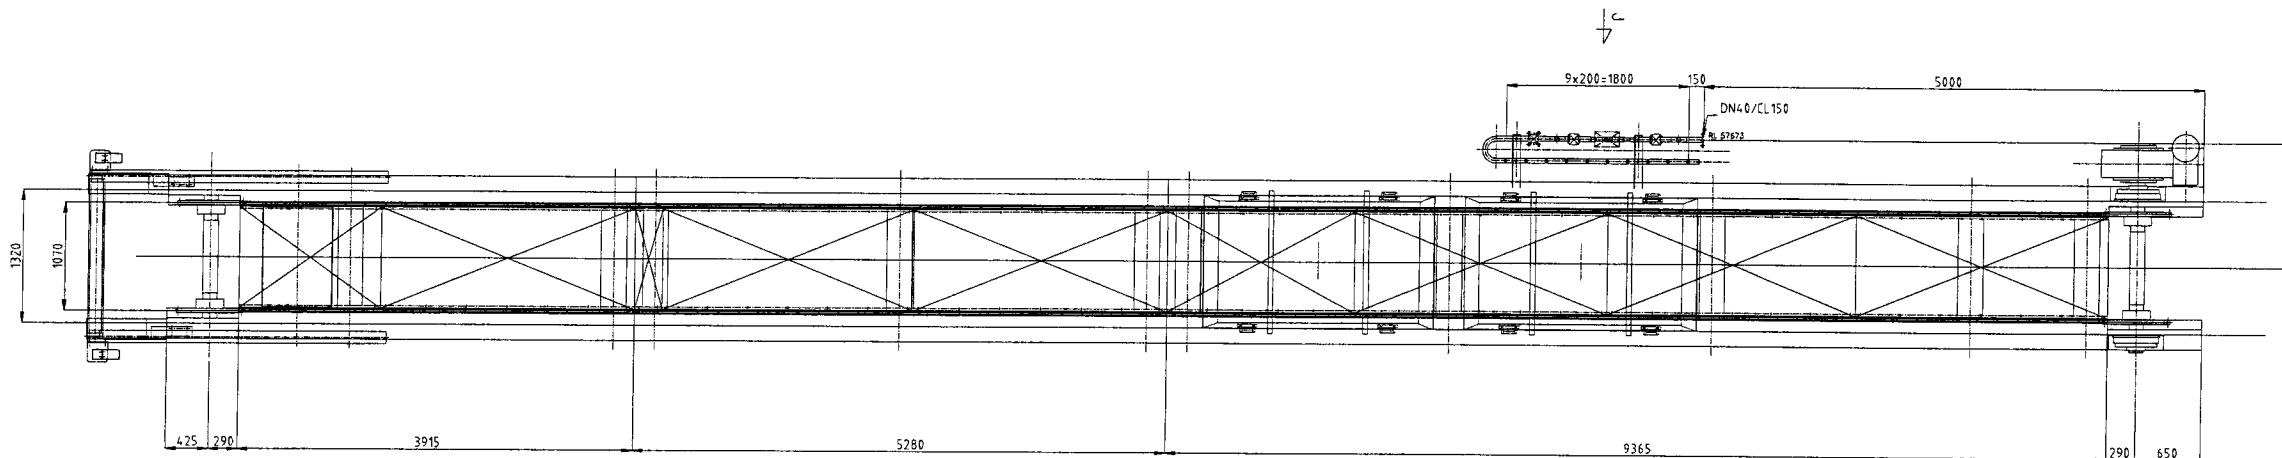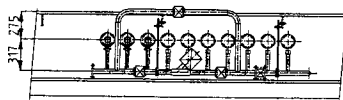


COUPE E

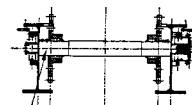

COUPE D

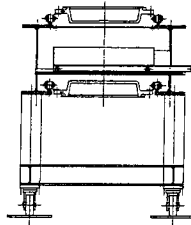


DETAIL U

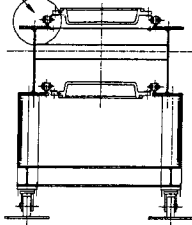


COUPE C


COUPE B

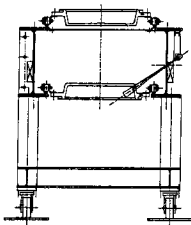


COUPE A

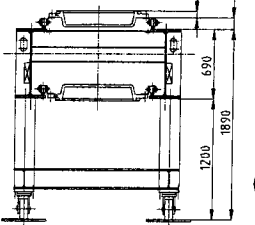


COUPE F

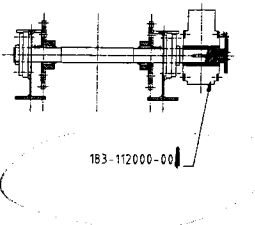


VIEW T

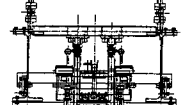


COUPE G

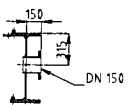


COUPE H

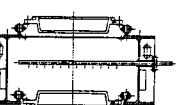

COUPE I

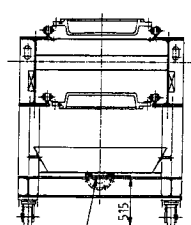

DETAIL U

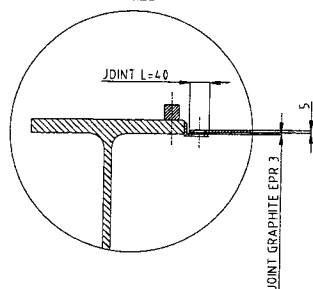

SMg Project Steel Mill Maintenance Project	
CERTIFIED SUPPLIER DATA STAMP	
Supplier Data No. <i>Q2050-SA-010-0200/01</i>	
ACCEPTED AS FINAL CERTIFIED DATA YES <input type="checkbox"/> NO <input checked="" type="checkbox"/> <i>Revise & Resubmit.</i>	
NAME <i>Colin Ward</i>	DATE <i>31/10/03</i>
THIS ACCEPTANCE DOES NOT RELIEVE THE SUPPLIER/CONTRACTOR OF ITS RESPONSIBILITY OR LIABILITY UNDER THE PO/CONTRACT	
CERTIFIED INFORMATION TO BE INCLUDED IN IOM/MDR	

Equipment No. *52-01-2-CM-001*

DOCUMENT NUMBER	REV
Q2050-SA-010-0200	XX

P012125

1-2

REV	Date	Drawn by	Verified by	Approved by	Modifications
01	24/10/03	LACHINE	GROSSEIN	BB	AS BUILT
02	01/02/03	GROSSEIN	BB	BB	Creation

BROCHOT SA Centre d'Activités Charles De Gaulle
52 Avenue Maréchal Juin
93397 TREUILAY en FRANCE Cedex
Tél. 33 (0)1 48 63 74 00
Fax. 33 (0)1 48 63 74 99
E-Mail: brochot@brochot.fr

Syprim
berger
Raffin

**CASTING CONVEYOR G.A.
LEFT TRAIN 1
122 INGOTS MOULDS 23 KGS**

183.110000.01.0