
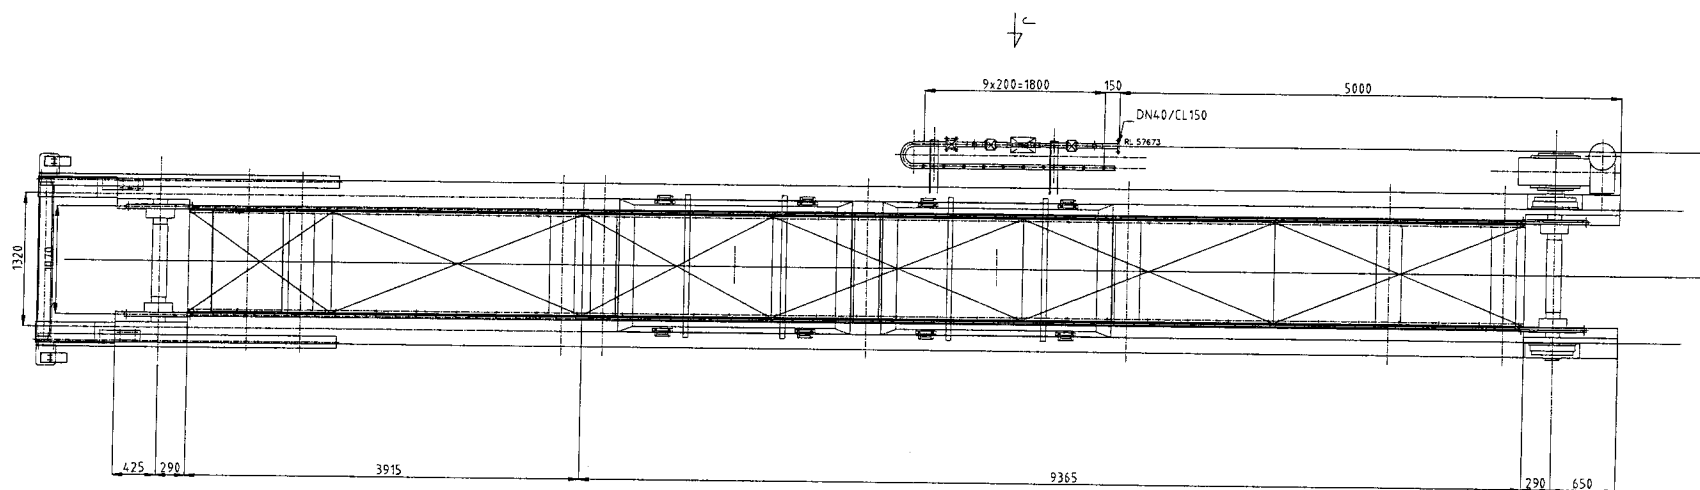
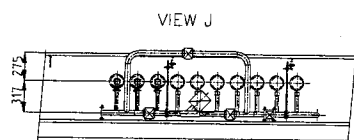


183-116300-001

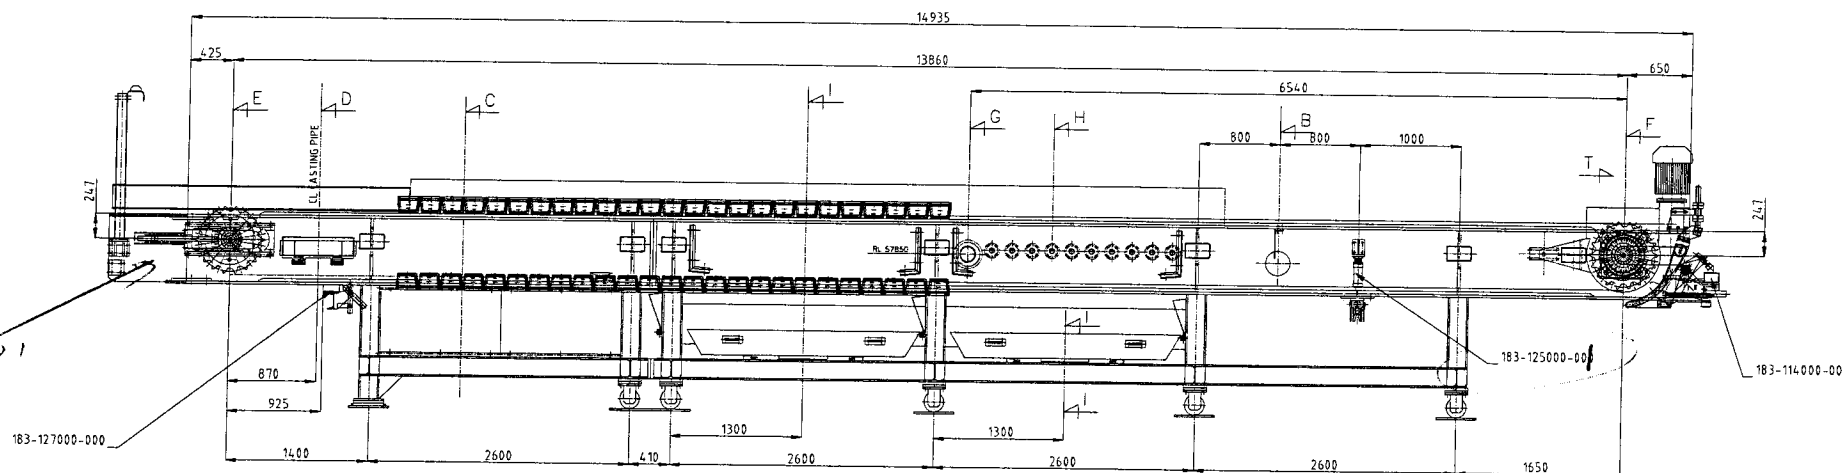

 SMg Project (Success) Magnesium Project	
CERTIFIED SUPPLIER DATA STAMP	
Supplier Data No. <i>0205-SA-010-0205/01</i>	
ACCEPTED AS FINAL CERTIFIED DATA	
YES <input type="checkbox"/> NO <input checked="" type="checkbox"/> <i>Revise & Resubmit.</i>	
NAME <i>Colin Ward</i>	
SIGNATURE <i>Colin Ward</i>	DATE <i>31/10/03</i>
THIS ACCEPTANCE DOES NOT RELIEVE THE SUPPLIER/CONTRACTOR OF ITS RESPONSIBILITY OR LIABILITY UNDER THE PO/CONTRACT	
CERTIFIED INFORMATION TO BE INCLUDED IN IOM/MDR	

COUPE E

COUPE D

DETAIL U

COUPE C

COUPE B

COUPE A










COUPE F

VIEW I

COUPE G

COUPE H

COUPE J

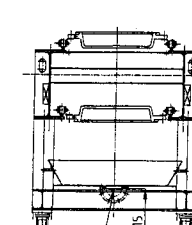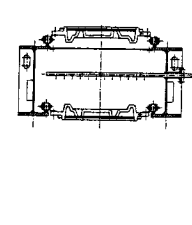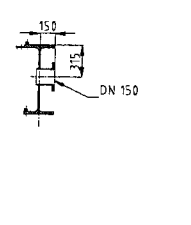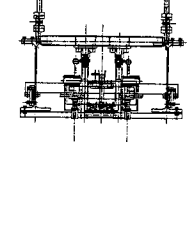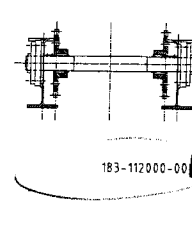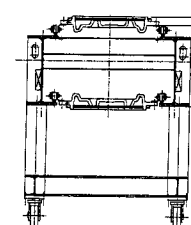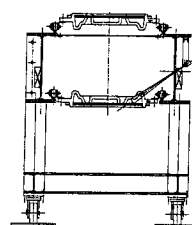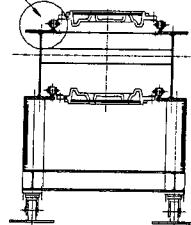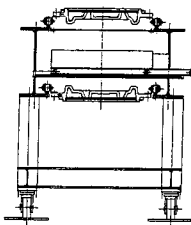


183-113000-00

Equipmen No. *52-02-2-CM-001*
52-03-2-CM-001

P012126

1-4

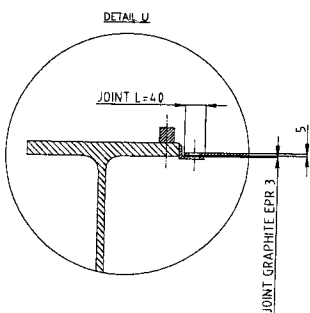

DOCUMENT NUMBER	REV
0205-SA-010-0205	XX

01	24/10/02	LACHMB	GROSSELM	BB	AS BUILT
02	07/07/02	GROSSELM	JCP	BB	Creation

Centre d'Activite Charies De Gaulle
 52 Avenue Marcellin Pélissier
 33937 THELIGNY EN FAUCONNEX
 Tel: 33 (0)1 49 63 74 00
 Fax: 33 (0)1 49 63 74 00
 E-Mail: brochot@brochot.fr

Syprim
 Berger
 Raffin

CASTING CONVEYOR G.A.
LEFT TRAIN 2 AND 3
135 INGOTS MOULDS 12 KGS

Scale: 1/25
 Number of Plan (Drawing Number): **183_120000_01_0**

Property of BROCHOT SA. May not be copied nor communicated to any third party without the written authorization of BROCHOT SA.